

SITE PLAN
SCALE IN FEET
0 50 100
NORTH


NOTE:
1. REFER TO CIP 05-467 FOR LAGOON IMPROVEMENTS

R. FULK J:\THORPRO\30735\CADD\PROCESS\AS-BUILTS\THORP007.DWG MAR 22, 2006
COPYRIGHT © 2004 BURNS AND McDONNELL ENGINEERS, INC.

no.	date	by	revision	no.	date	by	revision
A	02/10/04	P.D.F.	GMP BASE BID	7	12/22/04	M.A.L.	REVISED PER RFI 280
B	03/04/04	D.D.K.	ADDITION OF RO FEED LINE	8	12/7/05	P.D.F.	CONFORMING TO CONSTR. RECORDS
0	04/16/04	P.D.F.	ISSUE FOR CONSTRUCTION				
1	04/29/04	M.A.L.	ADDITION OF CASING/RFI 54				
2	05/28/04	M.A.L.	REVISED PER RFI 108 & SEWER ROUTING				
3	06/25/04	M.A.L.	RELOCATION OF UF FILTRATE LINE				
4	07/15/04	M.A.L.	REVISED PER RFI 141				
5	9/10/04	M.A.L.	REVISED GMP BASE BID PHASE II				
6	10/22/04	M.A.L.	ISSUE FOR CONSTRUCTION - PHASE II				



date JUNE, 2003 detailed R. FULK
designed D. KORINEK checked D.J.N.

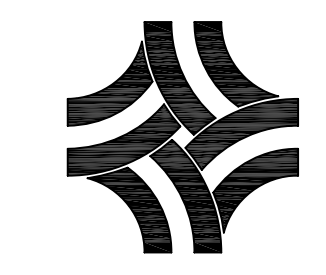

City of Thornton

WES BROWN WATER TREATMENT PLANT EXPANSION
YARD PIPING PLAN SHEET 1

project	contract
drawing P7	rev. 8
sheet	of sheets
file THORP007_ph2.dwg 12-22-2004 10:18 RWF	