

Drawings
For

Part 1:
**Thornton Water Treatment Plant
Clearwell and Pumping
Improvements**

Part 2: (NOT INCLUDED IN THIS SET)

**Thornton Parkway
24" Water Main**

1987

Job No's. 148-42-50 / 148-43-50



HDR Infrastructure, Inc.
A Centerra Company

"AS RECORDED"
FROM INFORMATION
PROVIDED BY THE
CONTRACTORS
DATE: OCT-14-88



Thornton Water Treatment Plant
Part 1



HDR Infrastructure, Inc.
A Centerra Company

DRAWING INDEX

1. COVER SHEET
2. VICINITY MAP/DRAWING INDEX

PART 1- THORNTON W.T.P. CLEARWELL & PUMPING IMPROVEMENTS

3. THORNTON W.T.P. - OVERALL SITE PLAN
4. 3.0 MG CLEARWELL - SITE PLAN
5. 3.0 MG CLEARWELL - PLAN, ELEVATIONS & DETAILS
6. 3.0 MG CLEARWELL - DETAILS
7. YARD PIPING - PROFILES
8. YARD PIPING - PROFILES & SECTIONS
9. YARD PIPING ALLEY - PROFILES
10. YARD PIPING - MISCELLANEOUS DETAILS
11. YARD PIPING - MISCELLANEOUS DETAILS
12. ZONE 4/3 PUMP STATION - PROCESS PLANS & SECTIONS
13. ZONE 4/3 PUMP STATION - PROCESS DETAILS
14. ZONE 4/3 PUMP STATION - INSTRUMENTATION
15. ZONE 4/3 PUMP STATION - HVAC
16. ZONE 4/3 PUMP STATION - HVAC DETAILS
17. ZONE 4/3 PUMP STATION - ELECTRICAL ONE-LINE DIAGRAM
18. ZONE 4/3 PUMP STATION - ELECTRICAL PLAN
19. ZONE 4/3 PUMP STATION - ELECTRICAL DETAILS
20. ZONE 4/3 PUMP STATION - ELECTRICAL DETAILS
21. THORNTON W.T.P. - ELECTRICAL SITE PLAN

PART 2 - THORNTON PARKWAY 24" WATER MAIN

22. PLAN & PROFILE - STA. 0+00 TO STA. 13+25
 23. PLAN & PROFILE - STA. 13+25 TO STA. 27+84
 24. PLAN & PROFILE - STA. 27+84 TO STA. 42+00
 25. PLAN & PROFILE - STA. 42+00 TO STA. 56+15
 26. PLAN & PROFILE - STA. 56+15 TO STA. 66+37
 27. MISCELLANEOUS DETAILS
 28. MISCELLANEOUS DETAILS
- 6A. RAW WATER LINE & VALVE VAULT

(NOT INCLUDED IN THIS SET)

"AS RECORDED"
FROM INFORMATION
PROVIDED BY THE
CONTRACTORS
DATE: 02-14-88

Thornton WTP
Clearwell &
Pumping
Improvements


Thornton
Parkway 24"
Water Main

Vicinity Map /
Drawing Index

Project Number	148-42-50
Date	November, 1986
Project Manager	G. Fuller
Design	J. Chwirka
Architectural	
Structural	C. Nyman
Mechanical	P. O'Brien
Electrical	M. Elzway
Drawn By	R. Bredsnajder
Revisions	10/14/88 AS BUILT REVISION



Sheet Number
2

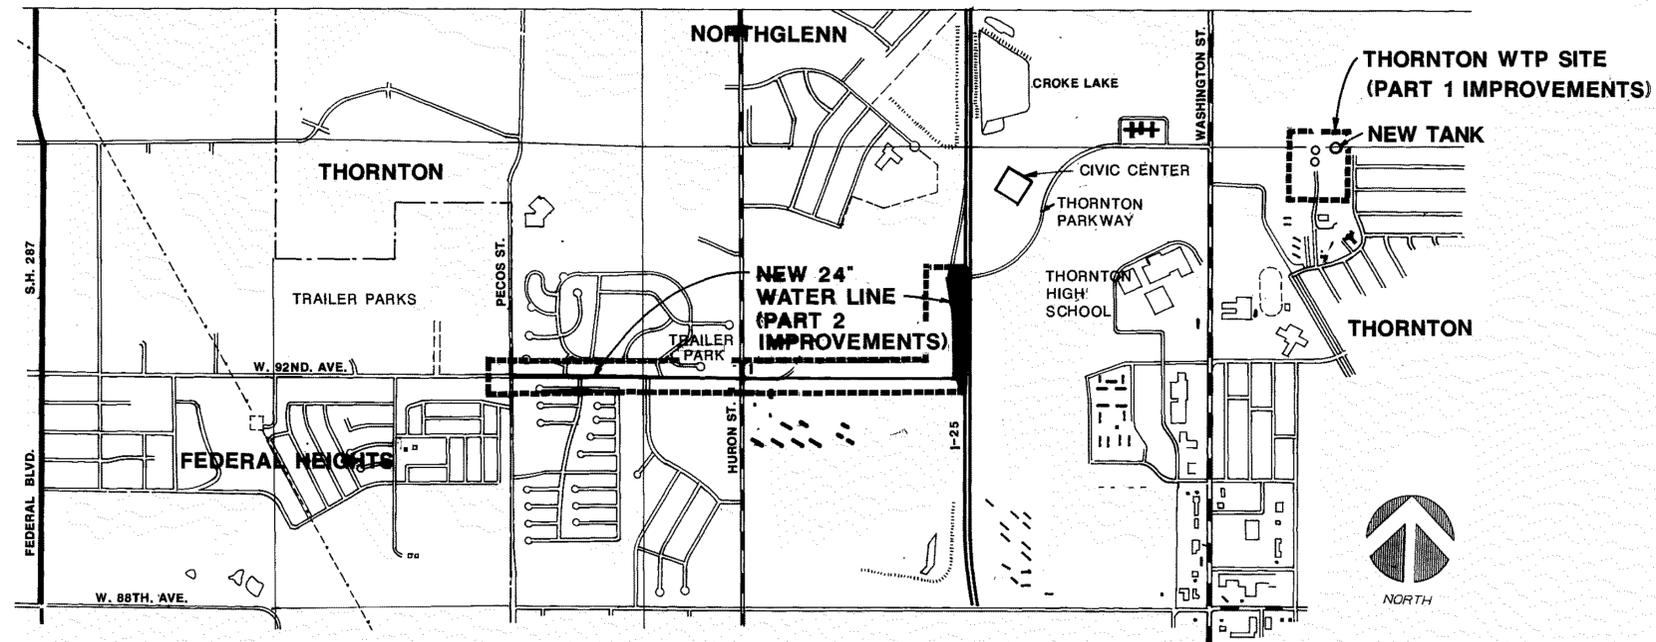


VICINITY MAP

SCALE: 1"=1000'

GENERAL NOTES:

1. CONTRACTOR SHALL FIELD VERIFY BY EXCAVATION ALL UTILITIES AND EXISTING PIPING AT LOCATIONS WHERE NEW PIPE CROSSES THE EXISTING UTILITY OR EXISTING PIPING. THE FIELD VERIFIED LOCATIONS AND ELEVATIONS SHALL BE REPORTED TO THE CITY AND THE ENGINEER.
2. ALL DUCTILE IRON PIPE JOINTS SHALL BE ELECTRICALLY CONNECTED USING #2 HMWPE TYPE VH CAWLEO CONNECTION OR PROVIDE OIP CAPABLE OF ACCEPTING BOLTED LUG CONNECTIONS. ALL CONNECTIONS OF DISSIMILAR MATERIALS SHALL BE INSTALLED WITH INSULATION GASKETS.
3. CONTRACTOR SHALL CONFINE ALL CONSTRUCTION ACTIVITIES TO THE AREAS DELINEATED ON THE DRAWINGS. CONTRACTOR SHALL COORDINATE ACCESS AT WTP SITE WITH OTHER CONTRACTOR.
4. ABANDON EXISTING 16" and 12" PIPING IN ALLEYWAY AT WTP AS NECESSARY TO INSTALL THE NEW 42" PIPE. ABANDONED PIPE NOT REMOVED FROM GROUND SHALL BE PLUGGED WITH CONCRETE. THE 12" LINE SHALL BE RECONNECTED TO THE RELOCATED 24" LINE AS SHOWN ON PLANS.
5. BURIED DUCTILE IRON PIPE SHALL BE RESTRAINED AS SHOWN ON DRAWING USING RESTRAINED JOINT PIPE. BURIED STEEL PIPE SHALL HAVE HARNESSED COUPLINGS EVERY 40 FEET MAXIMUM.
6. DUCTILE IRON PIPE SHALL BE CLASS 51 IN AREAS UNDER PAVEMENT AND CLASS 52 IN AREAS OF OPEN FIELD AS SHOWN ON THE PLANS. ALL DUCTILE IRON PIPE SHALL BE WRAPPED WITH 8 MIL POLYETHYLENE ENCASEMENT AS PER AWWA C105.
7. CONTRACTOR SHALL REMOVE AND REPLACE EXISTING ASPHALT TO THE EXTENT SHOWN ON THE PLANS. ASPHALT SHALL BE HOT MIX USING TYPE E AGGREGATE GRAOATION. THE AGGREGATE BASE SHALL BE CLASS 6. BOTH THE HOT BITUMINOUS PAVEMENT AND THE AGGREGATE BASE COURSE SHALL CONFORM TO COLORADO DEPARTMENT OF HIGHWAY SPECIFICATIONS.
8. ALL DISTURBED AREAS SHALL BE REGRADED AND SEEDED TO REESTABLISH VEGETATIVE COVER.

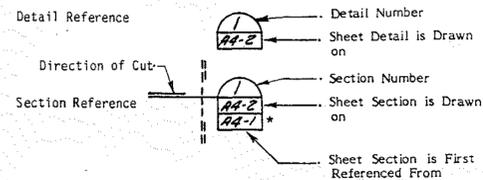





* Orientation Should be as Shown



Part 1:
Thornton
Water
Treatment
Plant
Clearwell &
Pumping
Improvements

Clearwell
Site Plan

Project Number	148-42-50
Date	November, 1986
Project Manager	G. Fuller
Design	J. Chwirka
Architectural	
Structural	C. Nyman
Mechanical	P. O'Brien
Electrical	M. Elzway
Drawn By	R. Bredsnajder
Revisions	10/14/88 As BUILT REVISIONS

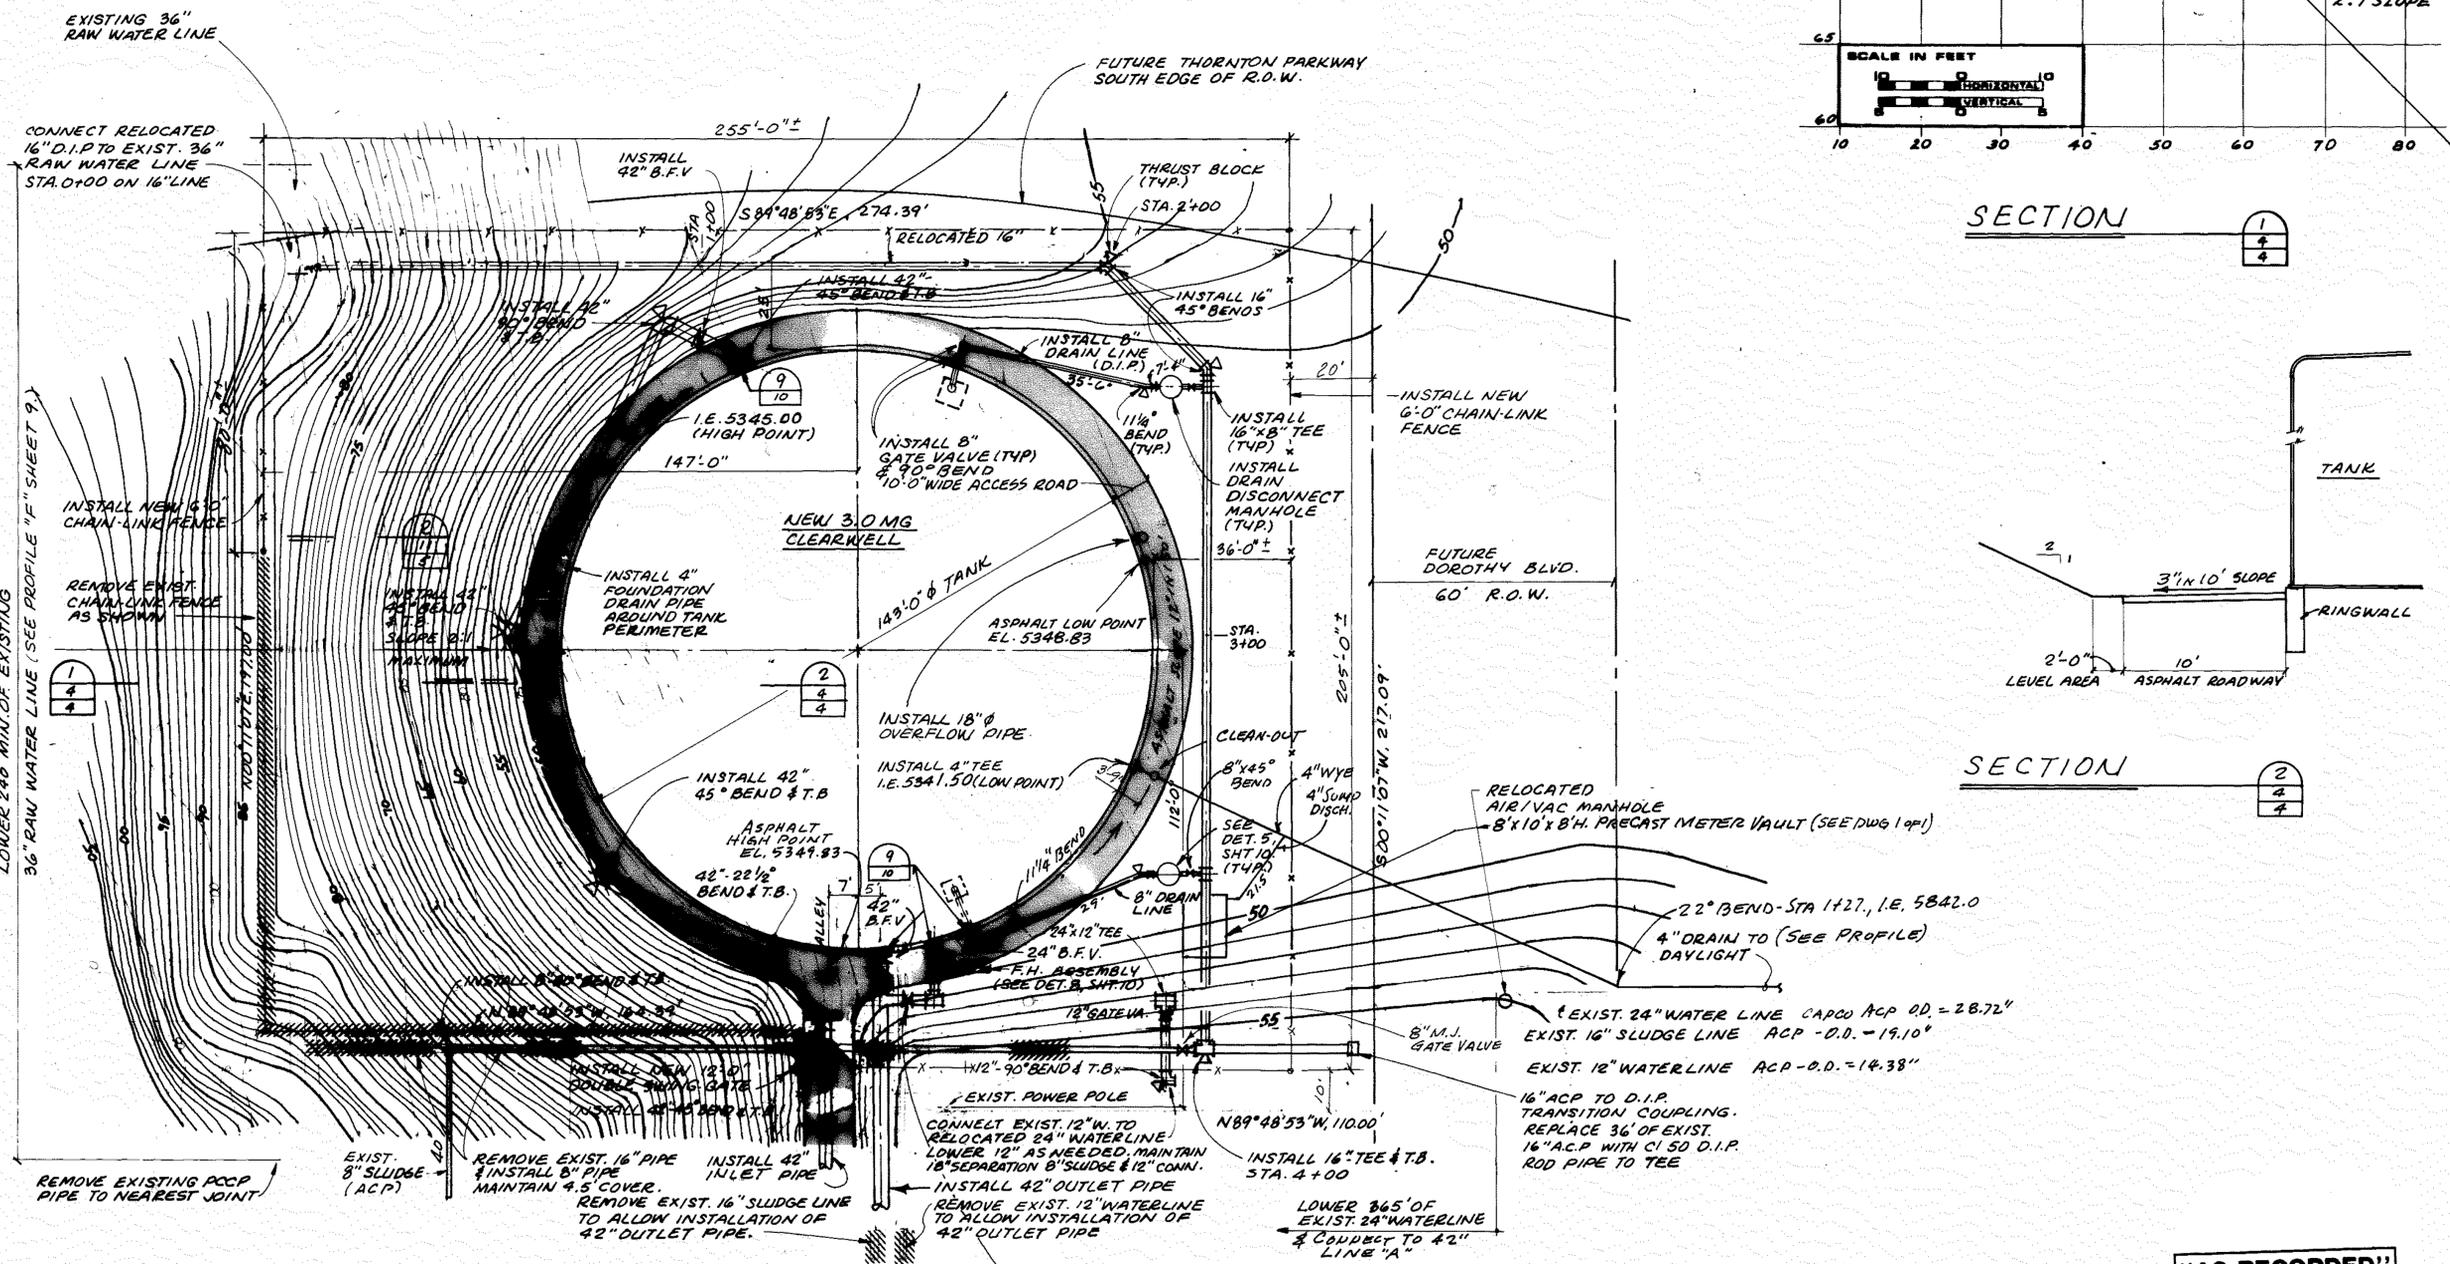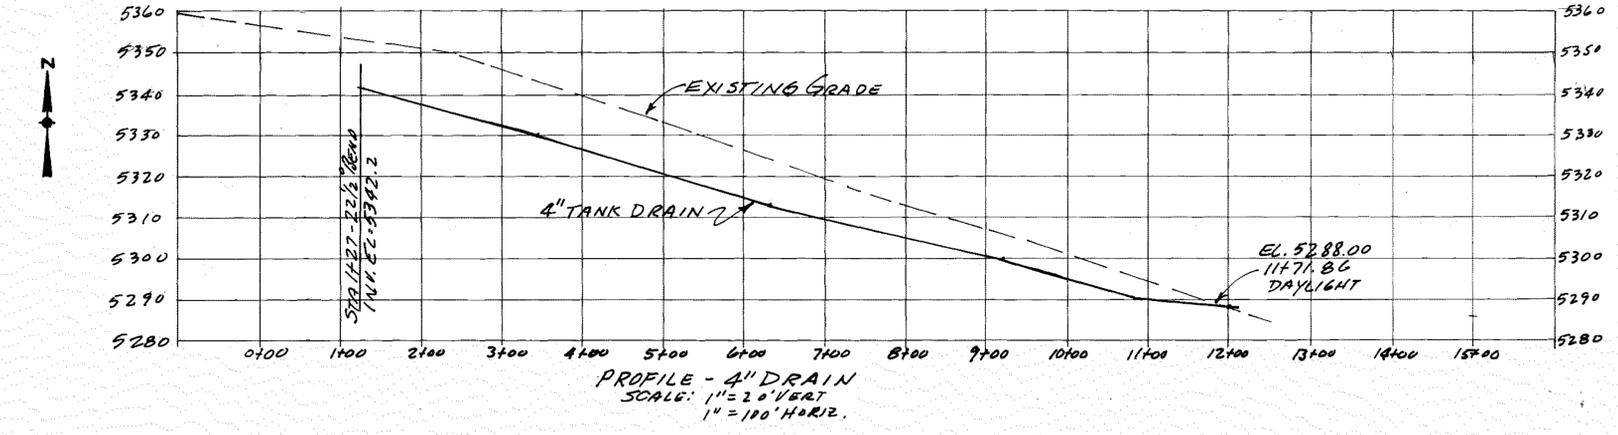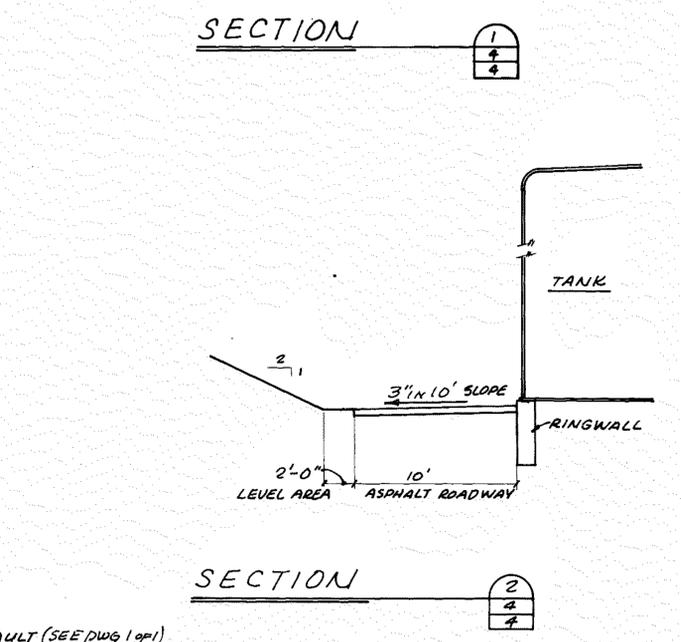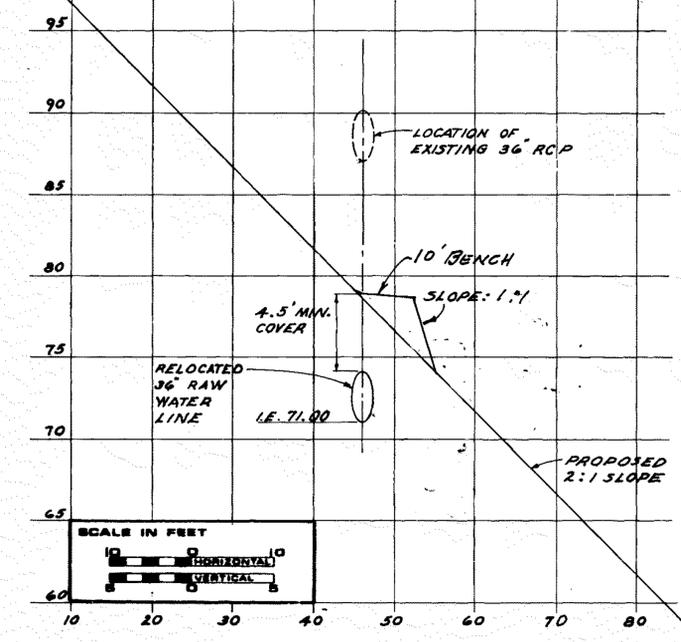

PLAN
SCALE: 1" = 20'

CONNECT RELOCATED 24" LINE TO 42" LINE "A", AFTER 42" LINE "B" IS IN SERVICE (SEE DETAILS SHEET 7)

"AS RECORDED"
FROM INFORMATION
PROVIDED BY THE
CONTRACTORS
DATE: OCT-14-89

AUDIT	007	007
OVERLAY	006	007
	004	004




HDR Infrastructure, Inc.
A Centerra Company


Part 1:
Thomton
Water
Treatment
Plant
Clearwell &
Pumping
Improvements

3.0 MG
Clearwell


Project Number	148-42-50
Date	November, 1988
Project Manager	G. Fuller
Design	J. Chwirka
Architectural	
Structural	C. Nyman
Mechanical	P. O'Brien
Electrical	M. Elzway
Drawn By	R. Bredsnajder
Revised	10/14/88 As Built Revisions

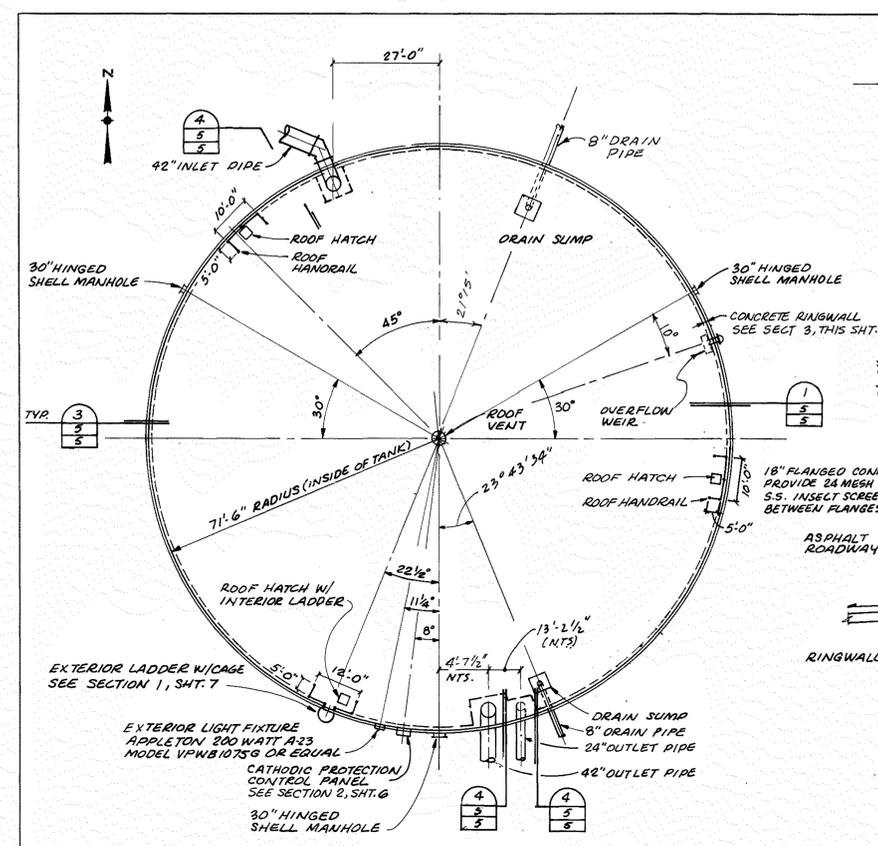


TANK PLAN
SCALE: 1/16" = 1'-0"

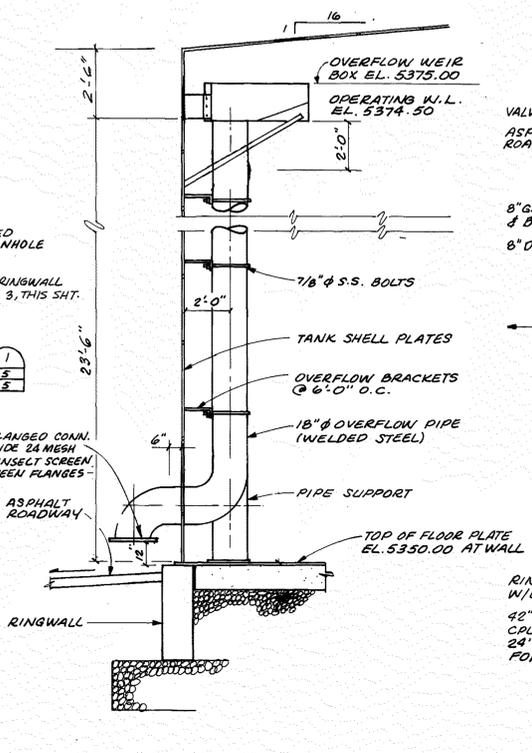


SECTION
SCALE: 3/8" = 1'-0"

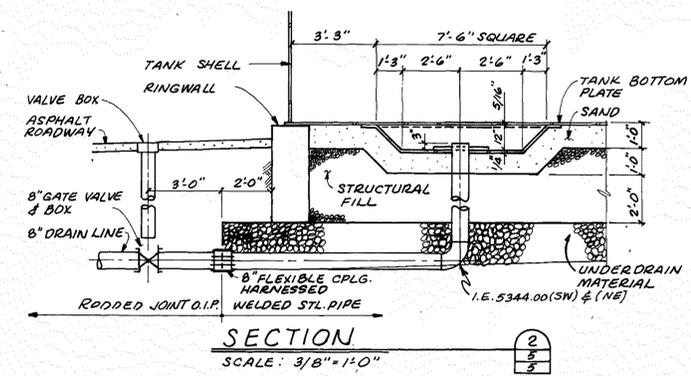


SECTION
SCALE: 3/8" = 1'-0"

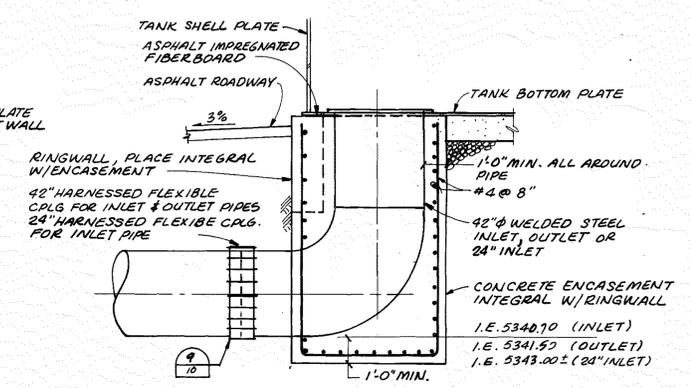

SECTION
SCALE: 3/8" = 1'-0"

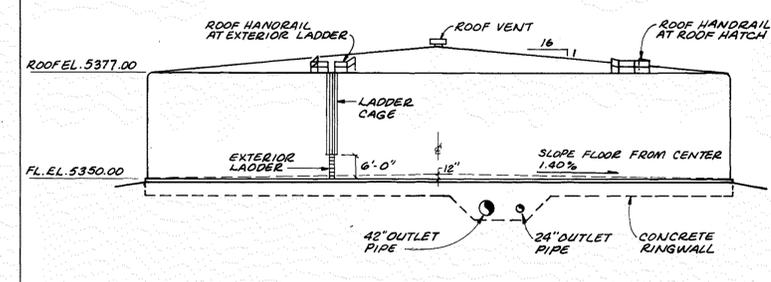

SOUTH ELEVATION
SCALE: 1/16" = 1'-0"

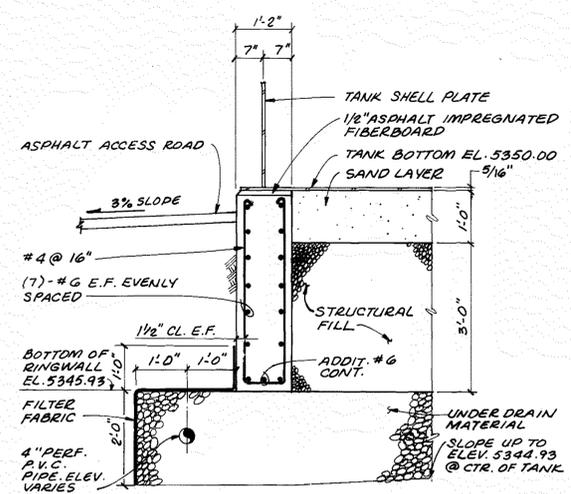

SECTION
SCALE: 3/4" = 1'-0"

- NOTES:
1. PROVIDE STD. 90° HK E.E. ON ALL WALL HORIZ. REINFORCING. EXTEND BOTH INSIDE FACE & OUTSIDE FACE REBARS TO OUTSIDE FACE OF INTERSECTING WALLS.
 2. VERIFY NUMBER, SIZE, AND LOCATION OF ALL WALL & SLAB DRNGS. PROVIDE ADDITIONAL REINFORCING AS SHOWN AND CUT INTERFERING REINF. AS REQUIRED.
 3. RING WALL HORIZONTAL SPlicing SHALL BE SPliced SO LAPS OF ADJACENT REBAR ARE STAGGERED, PROVIDE MINIMUM OF 3'-6" BETWEEN LAP LOCATIONS OF REBAR ADJACENT TO REBAR BEING SPliced. IN ALL CASES, PROVIDE MINIMUM OF 1'-2" CLEAR BETWEEN REBAR.
 4. CONCRETE STRENGTH : 4000 PSI
 5. REINFORCING STEEL : ASTM A615 GRADE 60
 6. FILL AND BACKFILL MATERIALS
 - a) SAND : CLASS C FILTER MATERIAL PER C.D.O.H. SPECIFICATIONS.
 - b) STRUCTURAL FILL : NON EXPANSIVE GRANULAR MATERIAL WITH A MINIMUM OF 20% PASSING A NO. 200 SIEVE AND WITH A LIQUID LIMIT OF 30% (MAX) COMPACT TO 100% STANDARD PROCTOR DENSITY.
 - c) UNDERDRAIN MATERIAL : GRANULAR MATERIAL WITH LESS THAN 5% PASSING A NO. 200 SIEVE AND LESS THAN 50% PASSING A NO. 4 SIEVE. MAXIMUM SIZE TO BE 2".

"AS RECORDED"
FROM INFORMATION
PROVIDED BY THE
CONTRACTORS
DATE: OCT-14-88





Sheet Number
5




Part 1:
Thornton
Water
Treatment
Plant
Clearwell &
Pumping
Improvements

3.0 MG
Clearwell

Project Number	148-42-50
Date	November, 1986
Project Manager	G. Fuller
Design	J. Chwirka
Architectural	
Structural	C. Nyman
Mechanical	P. O'Brien
Electrical	M. Elzway
Drawn By	R. Bredsnajder
Revisions	10/14/88 AS BUILT REVISIONS

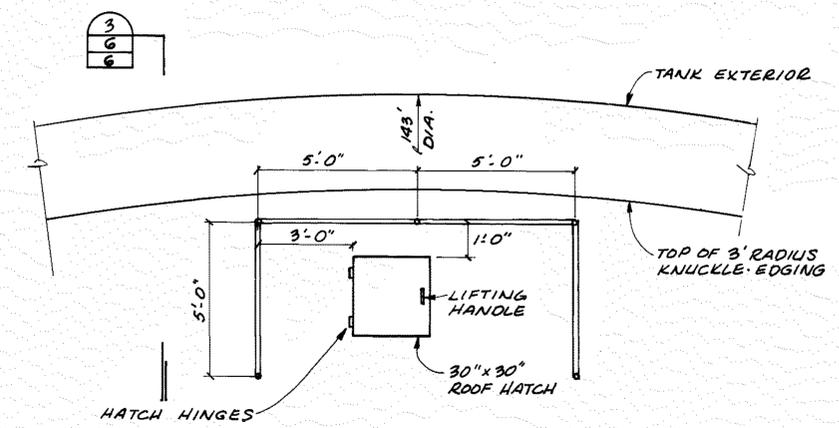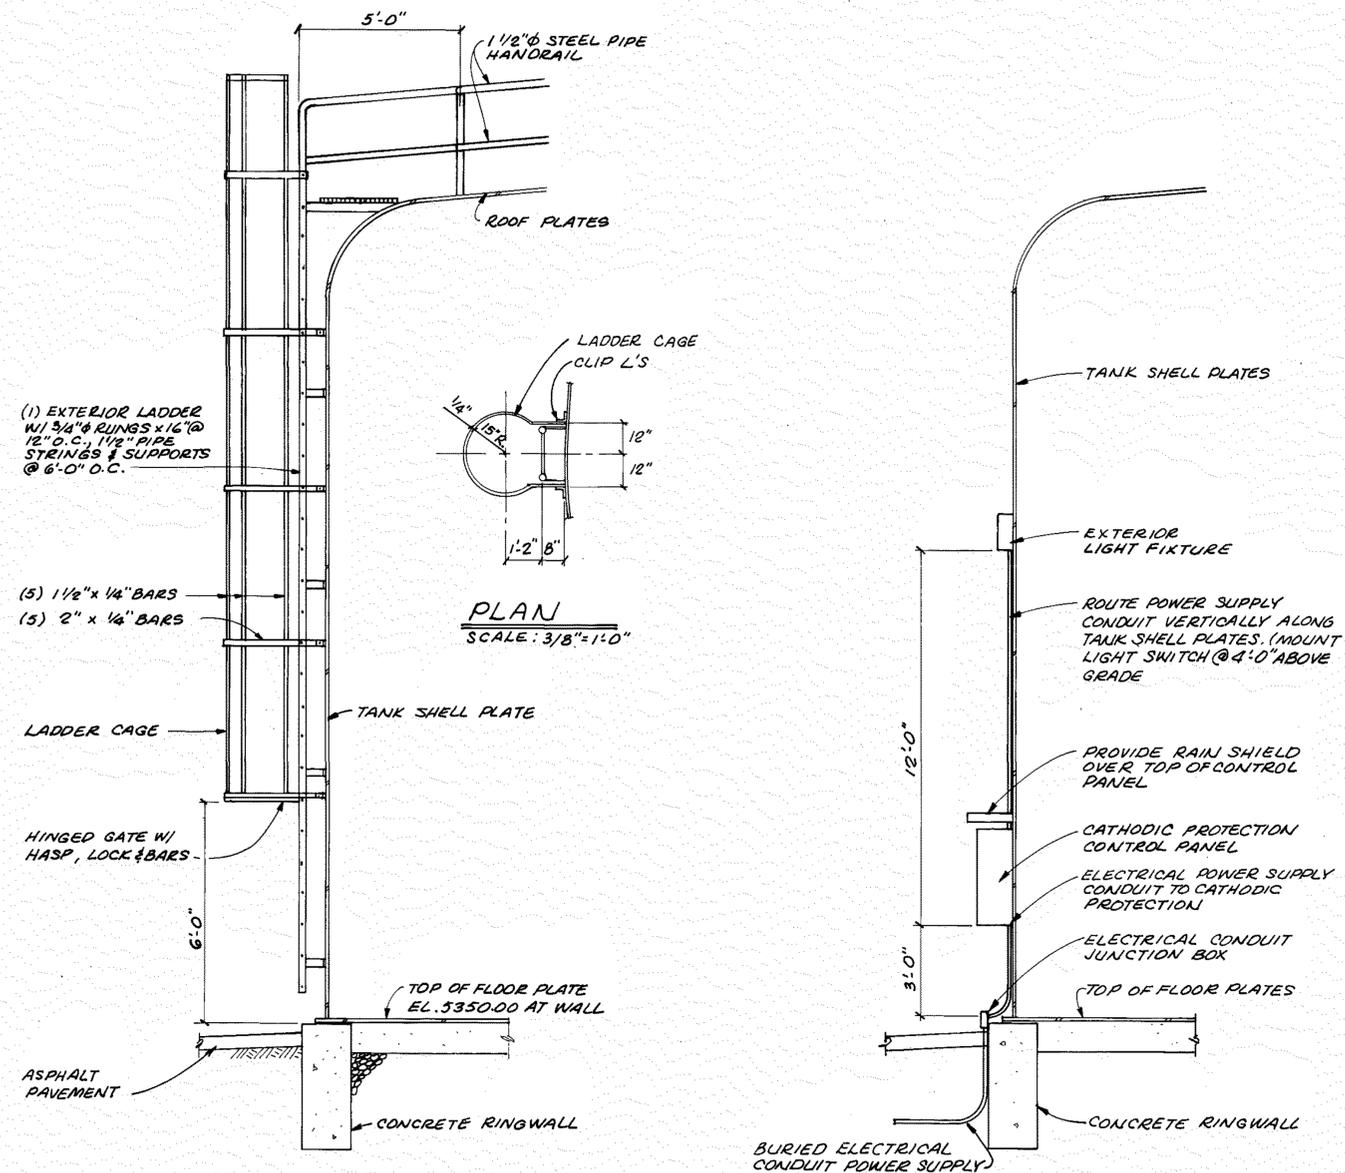


ROOF HATCH PLAN
SCALE: 3/8" = 1'-0"

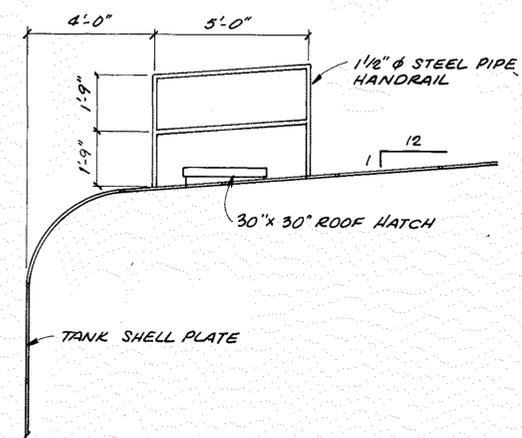


SECTION
SCALE: 3/8" = 1'-0"

SECTION
SCALE: 3/8" = 1'-0"


SECTION
SCALE: 3/8" = 1'-0"

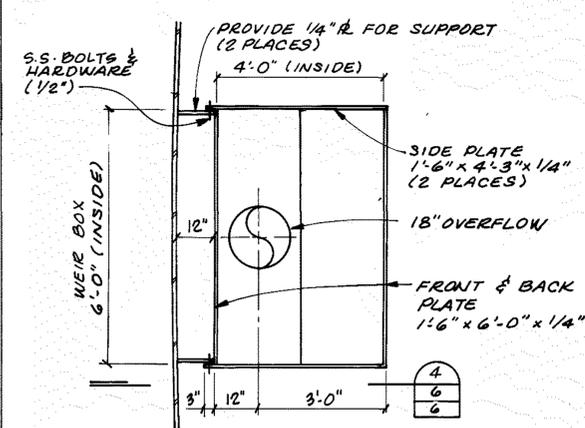

OVERFLOW WEIR BOX PLAN
SCALE: 1/2" = 1'-0"

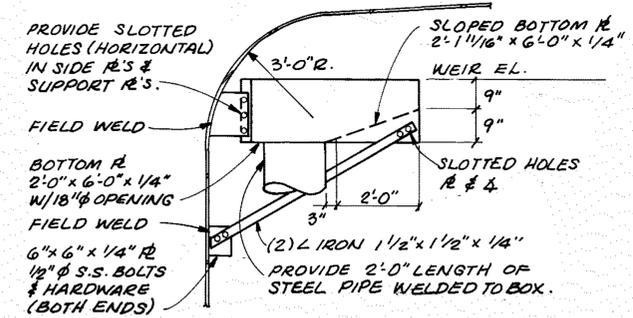

SECTION
SCALE: 1/2" = 1'-0"

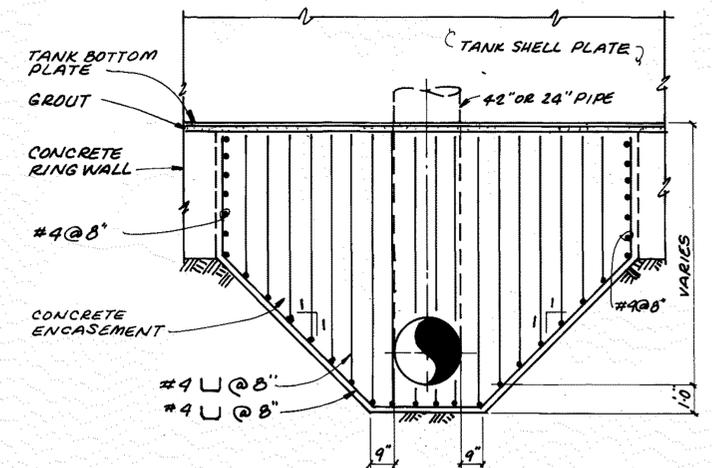

DETAIL
SCALE: 3/8" = 1'-0"

"AS RECORDED"
FROM INFORMATION
PROVIDED BY THE
CONTRACTORS
DATE: OCT-14-88









HDR Infrastructure, Inc.
A Centerra Company

**Part 1:
Thornton
Water
Treatment
Plant
Clearwell &
Pumping
Improvements**

**RAW WATER
LINE
VALVE VAULT**

Project Number	148-42-50
Date	April, 1987
Project Manager	G. Fuller
Design	J. Chwirka
Architectural	
Structural	C. Nyman
Mechanical	P. O'Brien
Electrical	R. SASAKURA
Drawn By	A. Tacito
Revisions	<ul style="list-style-type: none"> 4-21-87 REVISED PER CITY COMMENTS. 7-30-87 REVISED PER CITY REQUEST 8-10-87 REVISED PER CITY REQUEST 8-31-87 ADDED SUMP PUMP & CATHODIC PROT. TO ONE-LINE DIAGRAM. 10/14/88 AS BUILT REVISIONS.
Sheet Number	6A

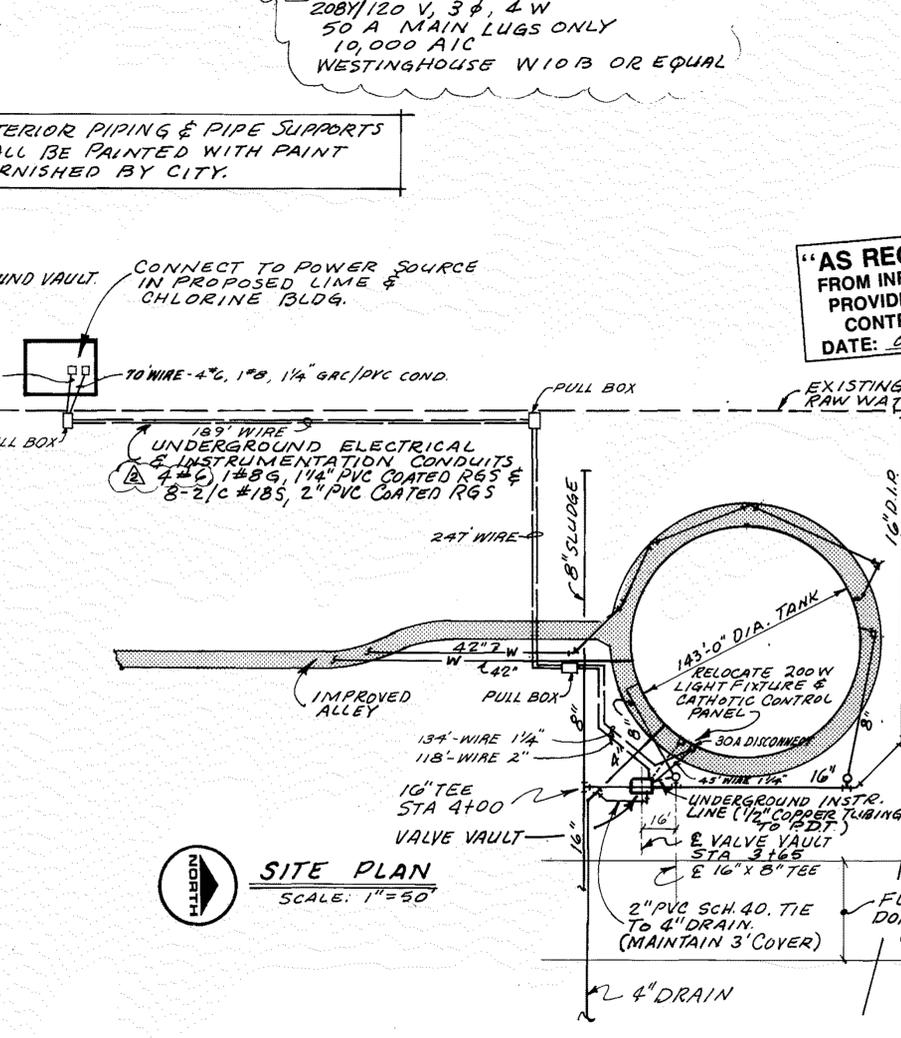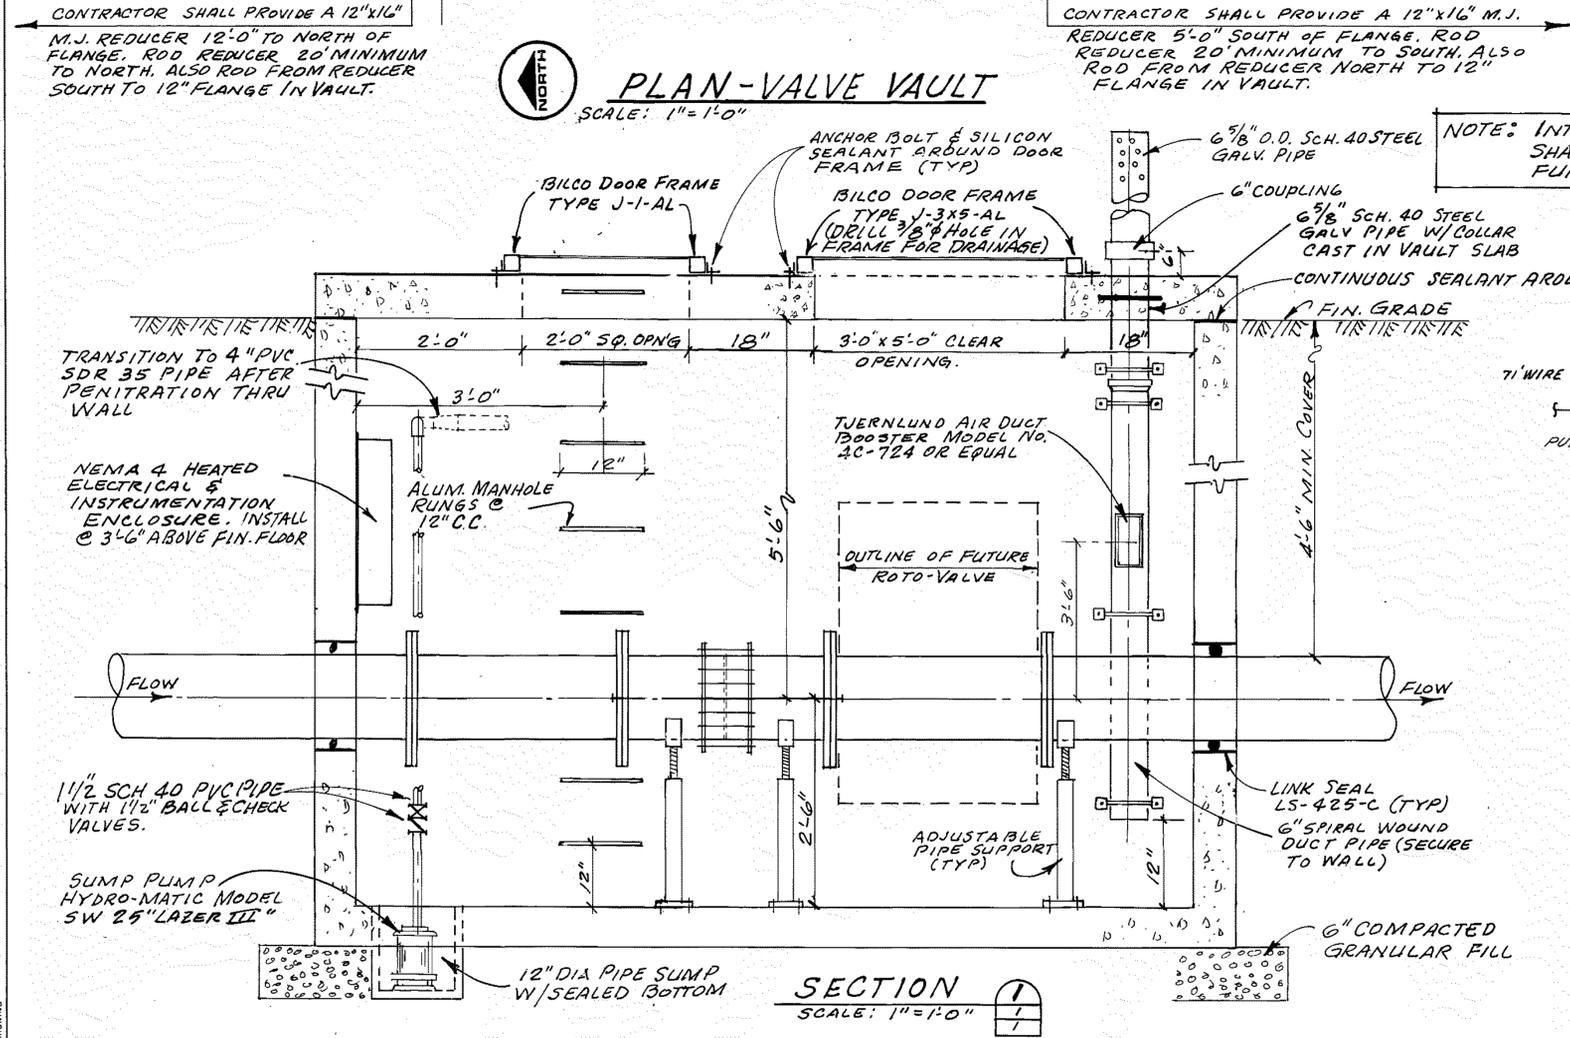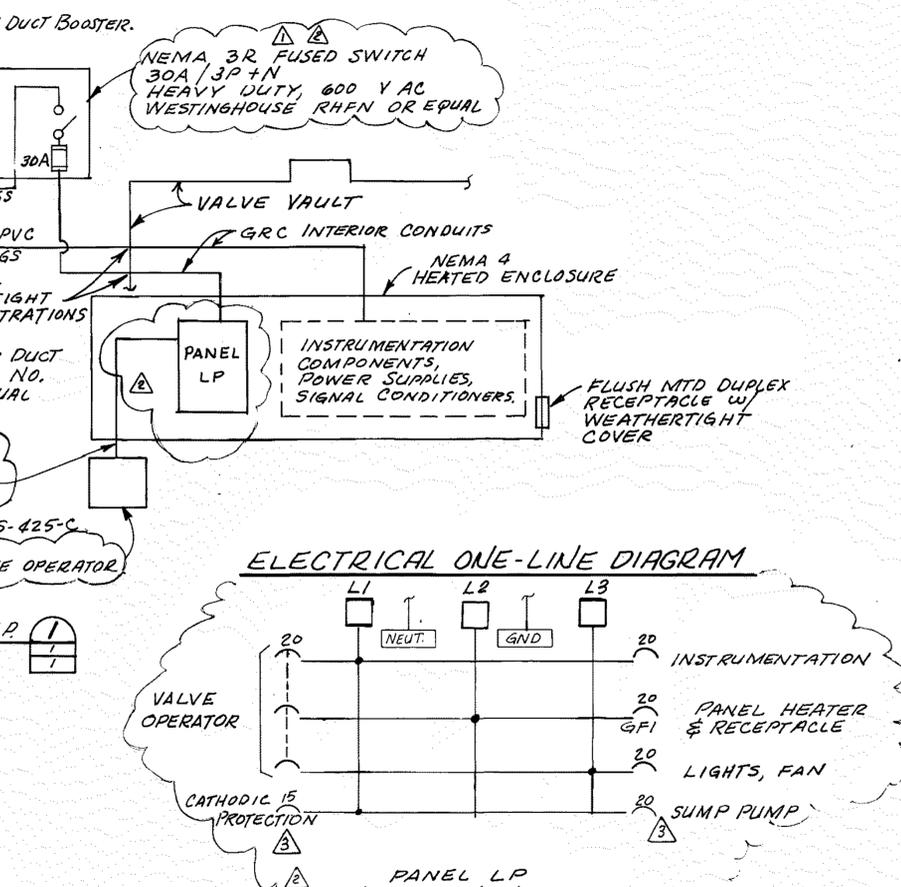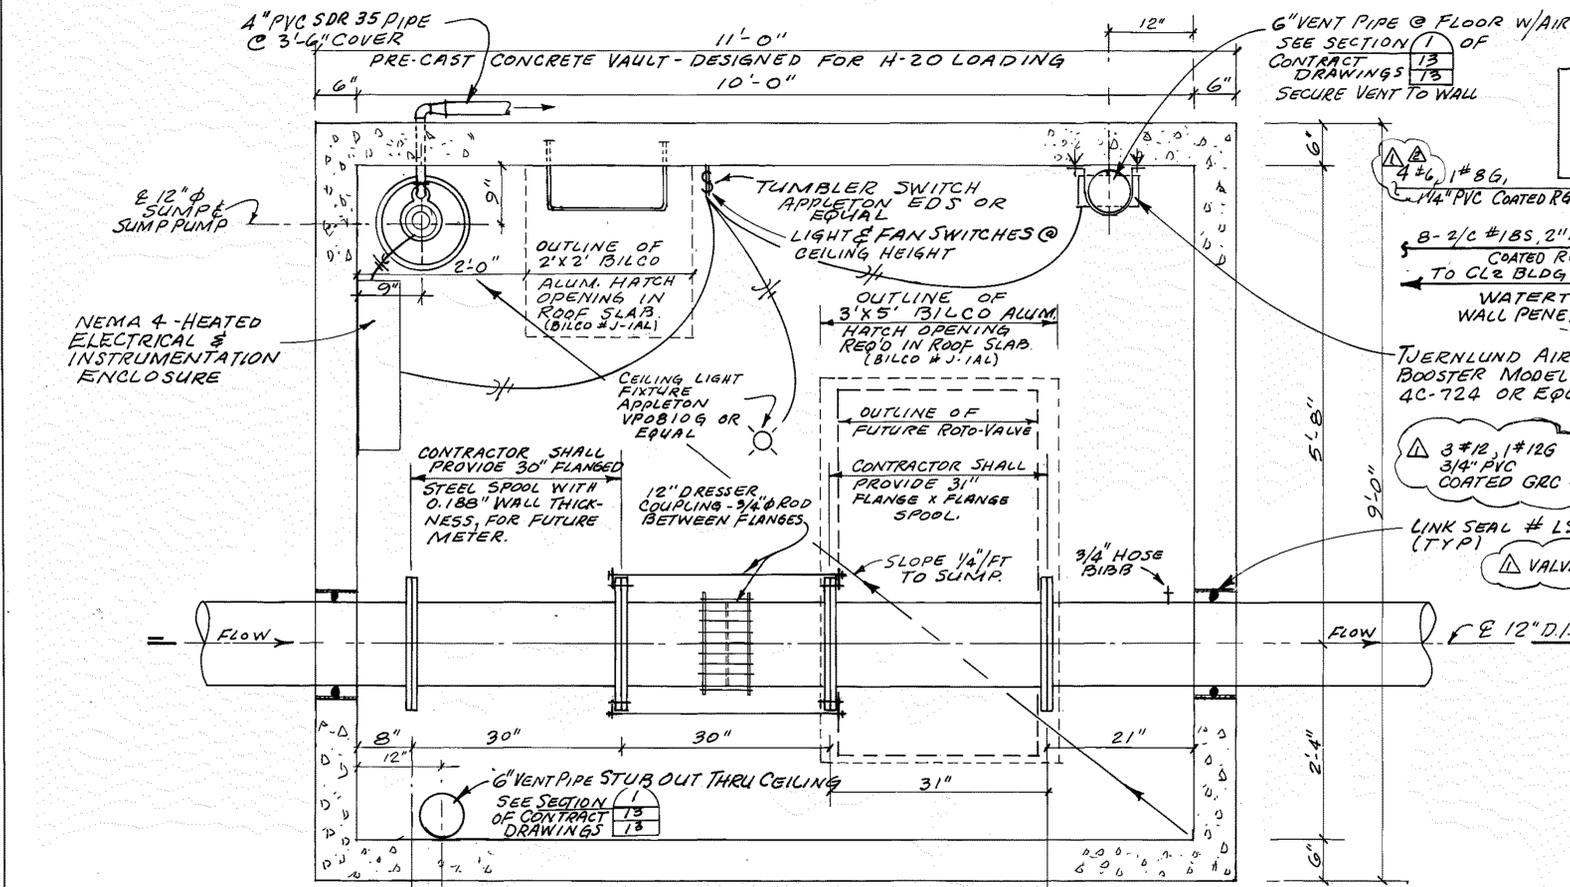



HDR Infrastructure, Inc.
A Centerra Company


Part 1:
Thornton
Water
Treatment
Plant
Clearwell &
Pumping
Improvements

Yard
Piping


Project Number	148-42-50
Date	November, 1986
Project Manager	G. Fuller
Design	J. Chwirka
Architectural	
Structural	C. Nyman
Mechanical	P. O'Brien
Electrical	M. Elzway
Drawn By	R. Bredsnajder
Revisions	10/14/88 As Built Revisions




Sheet Number
7

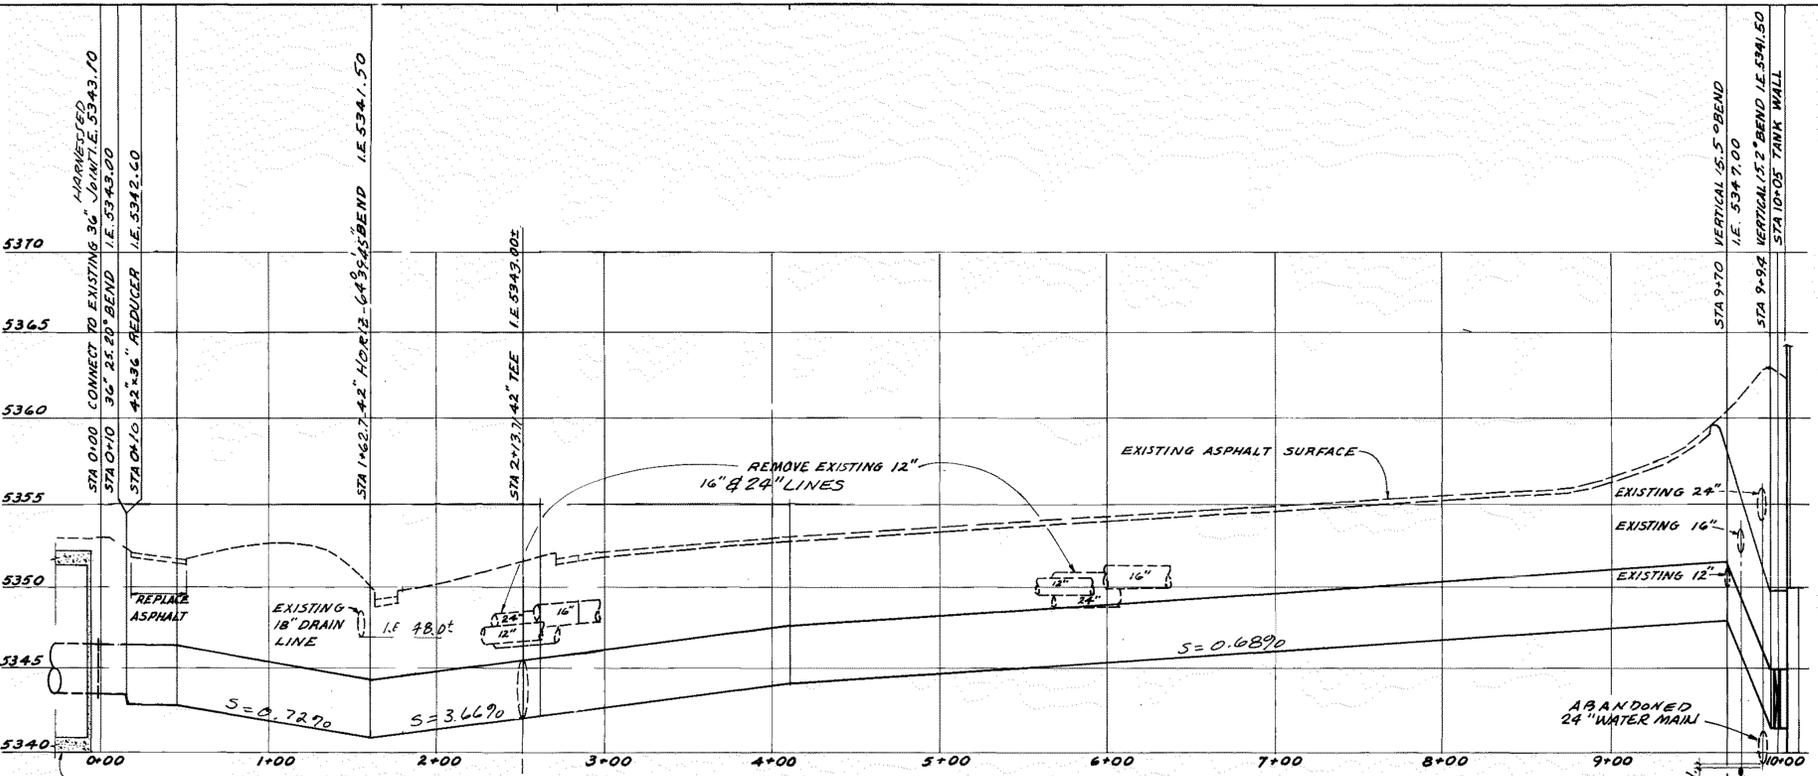


PROFILE 'A' - 42" OUTLET PIPE
SCALE: HORIZ. 1" = 50'
VERT. 1" = 5'

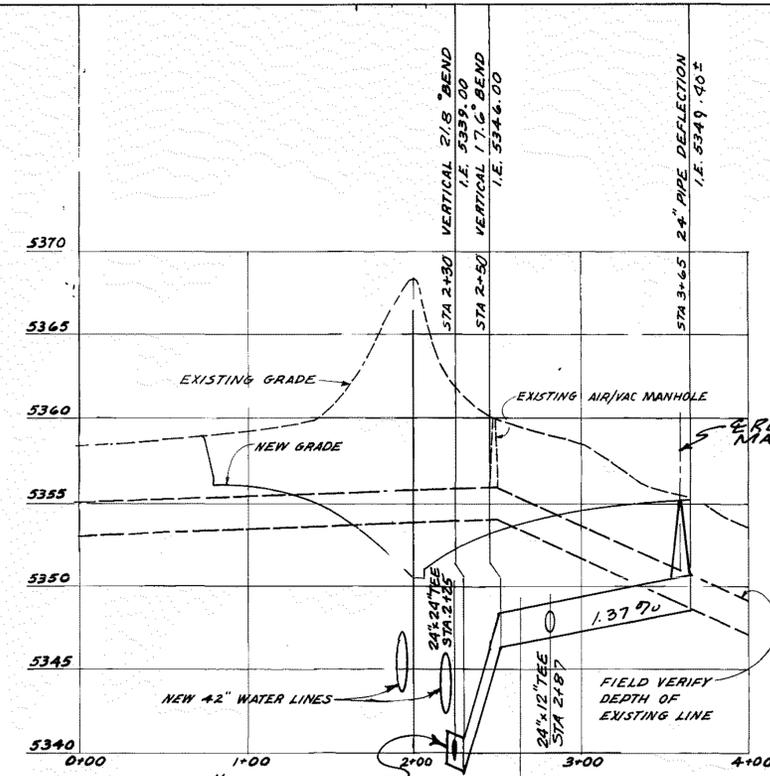

PROFILE C - RELOCATED 24" WATER LINE
SCALE: HORIZ. 1" = 50'
VERT. 1" = 5'

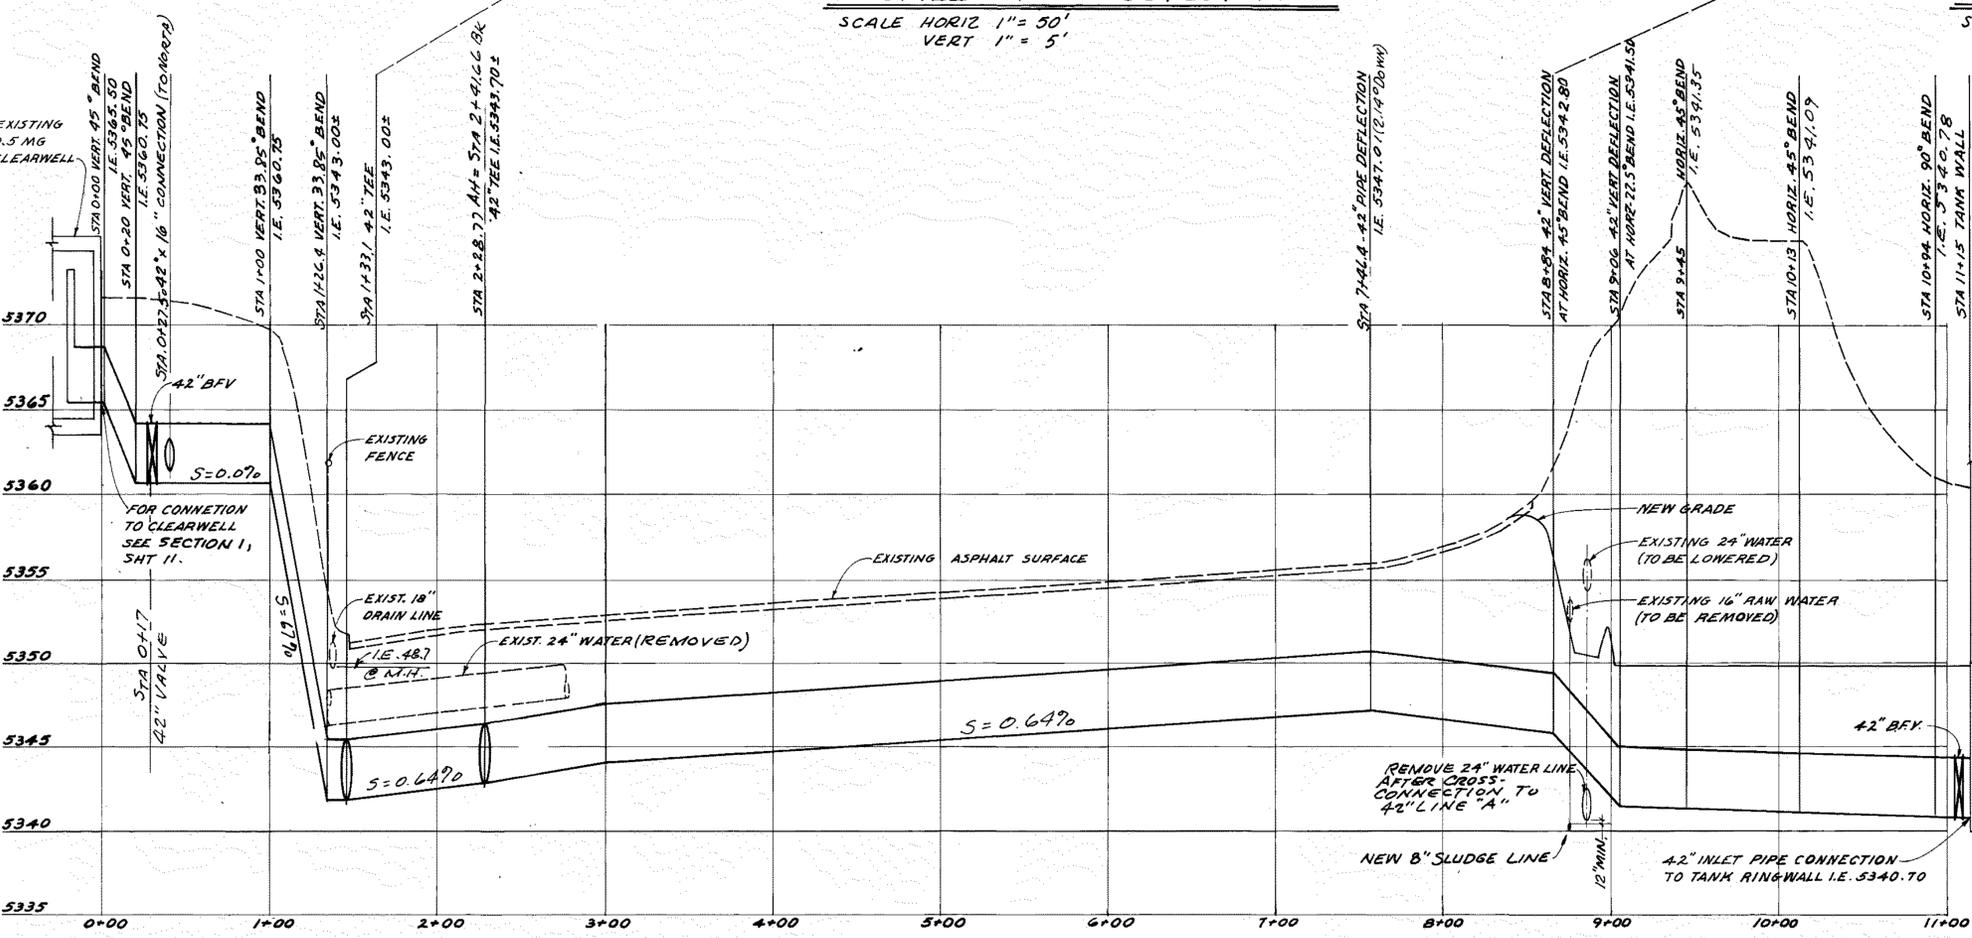

PROFILE 'B' - 42" INLET PIPE
SCALE: HORIZ. 1" = 50'
VERT. 1" = 5'

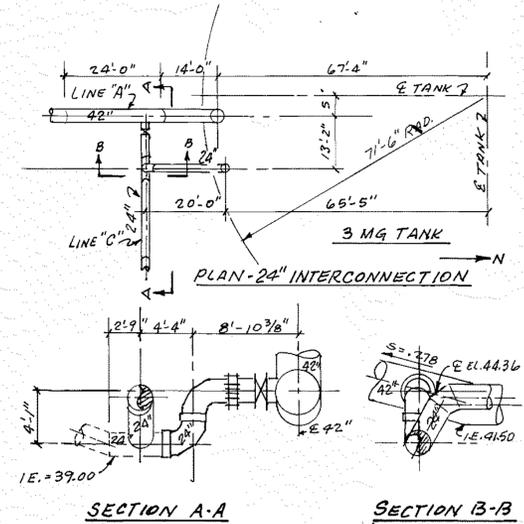

SECTION A-A
SECTION B-B
DETAIL A
NO SCALE

NOTE: THE ABOVE DETAIL "A" WAS TAKEN FROM THOMPSON PIPE & STEEL CO. SHOP DRAWING NO. 71, FILE NO. 3-B375, DATED 8-31-87.

"AS RECORDED"
FROM INFORMATION
PROVIDED BY THE
CONTRACTORS
DATE: OCT-14-88



HDR Infrastructure, Inc.
A Centerra Company


Part 1:
Thornton
Water
Treatment
Plant
Clearwell &
Pumping
Improvements

Yard
Piping


Project Number	148-42-50
Date	November, 1986
Project Manager	G. Fuller
Design	J. Chwirka
Architectural	
Structural	C. Nyman
Mechanical	P. O'Brien
Electrical	M. Elzway
Drawn By	R. Bredsnajder
Revisions	10/14/88 As Built REVISIONS




Sheet Number
8

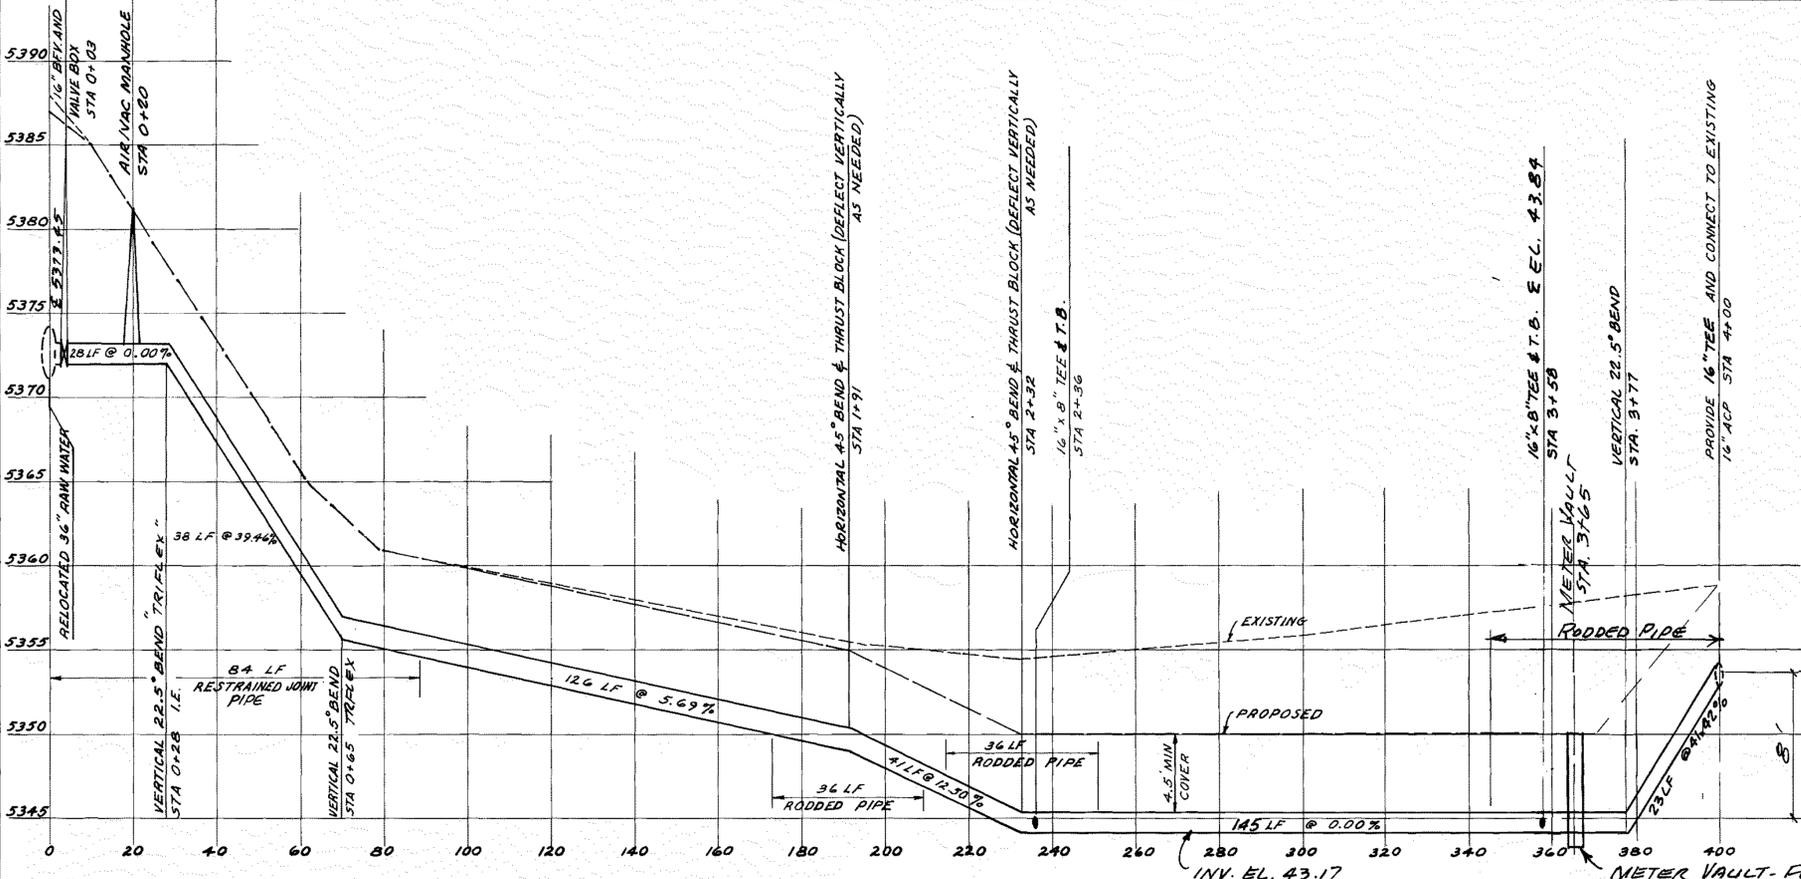


PROFILE "E" - RELOCATED 16" RAW WATER LINE
SCALE: HORIZ. 1" = 20'
VERT. 1" = 5'

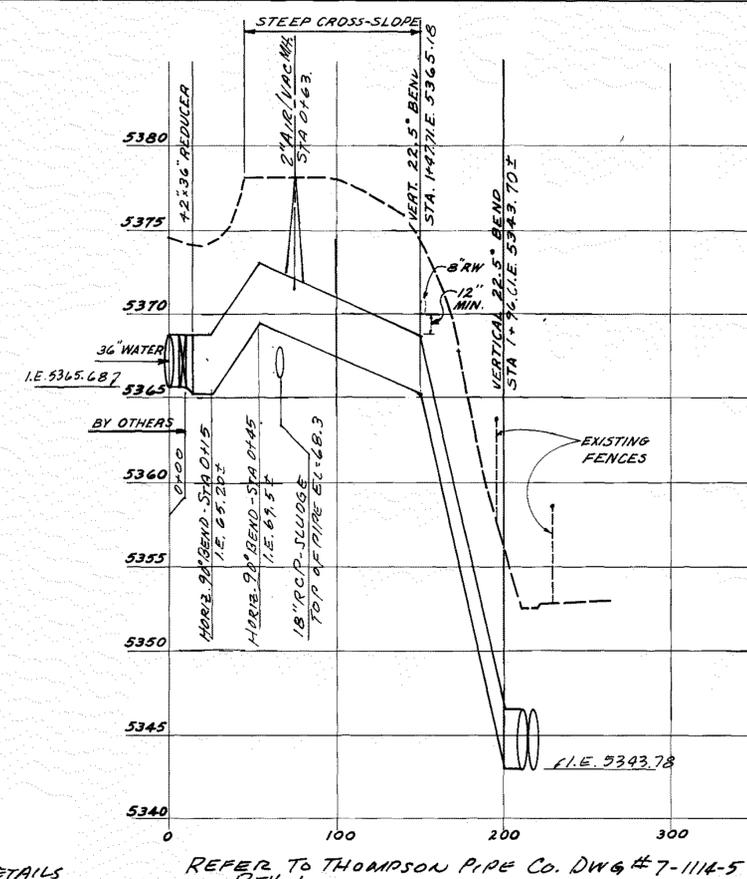



PROFILE "D" - 42" PIPE
SCALE: HORIZ. 1" = 50'
VERT. 1" = 5'

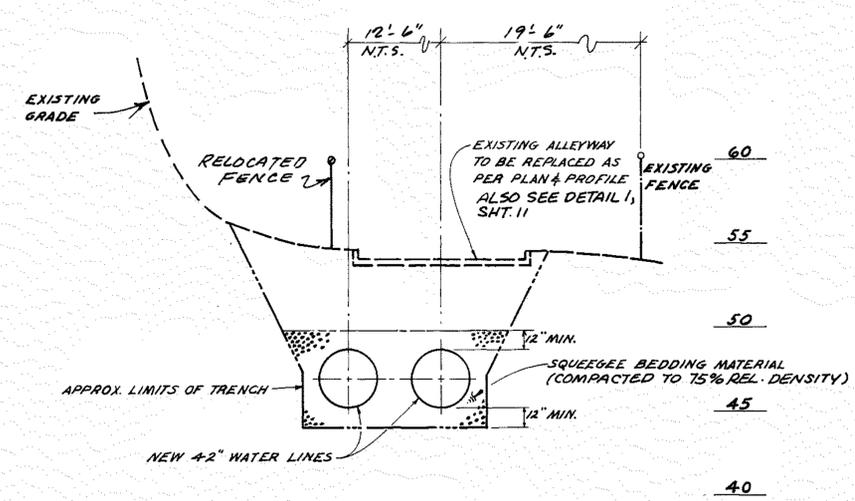

SECTION 1
SCALE: 1" = 5'-0"

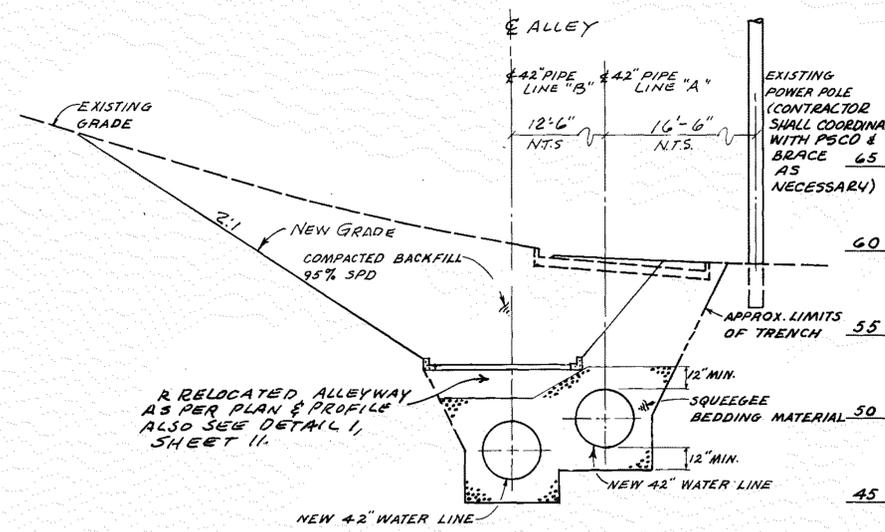

SECTION 2
SCALE: 1" = 5'-0"

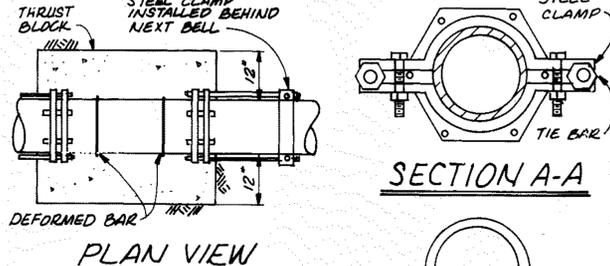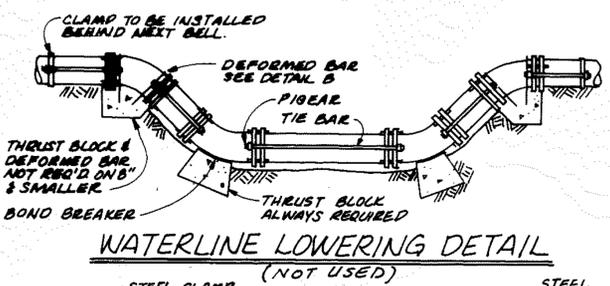

- NOTES:**
1. ALL PIPE USED IN LOWERING SHALL BE DUCTILE IRON PIPE WITH 8 MIL. POLYWRAP.
 2. ALL FITTINGS, PIPES & TIE BARS TO BE WRAPPED SEPARATELY IN POLYETHYLENE.
 3. 45° FITTINGS. SHALL BE USED.
 4. FITTINGS SHALL BE RODDED TO THE NEXT BELL & NO JOINTS ARE ALLOWED BETWEEN FITTINGS.
 5. PIGEARS SHALL BE USED ON RODDING FOR FITTINGS.

LINE SIZE	DEFORMED BAR DIAM.	TIE BAR DIAM.	AMOUNT
8"	-	-	.375
12"	.500	18"	.500
16"	.750	20"	.750
24"	1.000	24"	1.000

"AS RECORDED"
FROM INFORMATION
PROVIDED BY THE
CONTRACTORS
DATE: OCT-14-88

DETAIL B
SCALE: 1" = 5'-0"